

TO: **ALL BIDDERS OF RECORD**

FROM: BETA Group, Inc.
315 Norwood Park South
Norwood, MA 02062

SUBJECT: **ADDENDUM NO. 2 TO CONTRACT DOCUMENTS FOR
INTERSECTION IMPROVEMENTS – ROUTE 123 AT RATHBUN-
WILLARD DRIVE & BLACK OAK DRIVE
ATTLEBORO, MA**

DATE: January 24, 2022

I. ADDENDUM NO. 2

- A. This Addendum shall be made part of the Contract Documents.
- B. **EACH BIDDER MUST SIGN PAGE 3 OF THIS ADDENDUM NO. 2 -
“ADDENDUM NO. 2 RECEIPT ACKNOWLEDGEMENT FORM” -
AND SEND THIS PAGE ONLY TO MR. TYLER DE RUITER, VIA E-
MAIL AT TDERUITER@BETA-INC.COM**

II. QUESTIONS FROM BIDDERS

- A. Q. You have a completion date of August 26, 2022. Will this date be extended based on the lead time for the signal equipment since there is no way we can get it by the current completion date?
- A. The completion date is subject to the school re-opening. The project intersection will serve as an entrance for the New High School, the Middle School, and the Elementary School. The bidding contractor should check with the respective suppliers on availability of materials associated with this project before placing a bid. At this time, we don't anticipate a change in completion date.
- B. Q. There is a note on the plans saying tree protection will be as directed by the engineer. The tree protection is part of the lump sum site preparation item so in order for contractors to carry this work in their bid we need to know ahead of time what trees will require protection. Please add it to the drawings if you require it on any trees that aren't already called out for it.
- A. Additional tree protection has been added to the appropriate drawings. Revised drawings are attached.
- C. Q. Is item 864.02 for the preformed bicycle loop detector symbols? What is the unit of measurement for this item since it is missing from the bid form?
- A. This item will be used for the bicycle detection markings at the stop lines. The unit of measurement is square foot.

III. SPECIFICATIONS

- A. On page 00300-8, in the row for Item 864.02, please add “PER SQUARE FOOT” in the appropriate location.

IV. PLANS

- A. The following plan sheets have been revised and revision clouds applied to each revision location. These revisions do not require change in Item quantities.

Sheet 8 of 28, Rev 1

Sheet 9 of 28, Rev 1

Sheet 10 of 28, Rev 1

Sheet 11 of 28, Rev 1

ADDENDUM NO. 2 RECEIPT ACKNOWLEDGEMENT FORM

**PLEASE ACKNOWLEDGE RECEIPT OF THIS ADDENDUM NO. 2 BY
SIGNING BELOW AND RETURNING THIS SHEET ONLY TO THE BETA
GROUP, INC., ATTENTION MR. TYLER DE RUITER, VIA E-MAIL AT
TDERUITER@BETA-INC.COM**

**ADDENDUM NO. 2 TO CONTRACT DOCUMENTS FOR
INTERSECTION IMPROVEMENTS – ROUTE 123 AT RATHBUN-
WILLARD DRIVE & BLACK OAK DRIVE
ATTLEBORO, MA**


Signature _____

Name _____
(Please Print)


Title _____

Company _____

Date _____


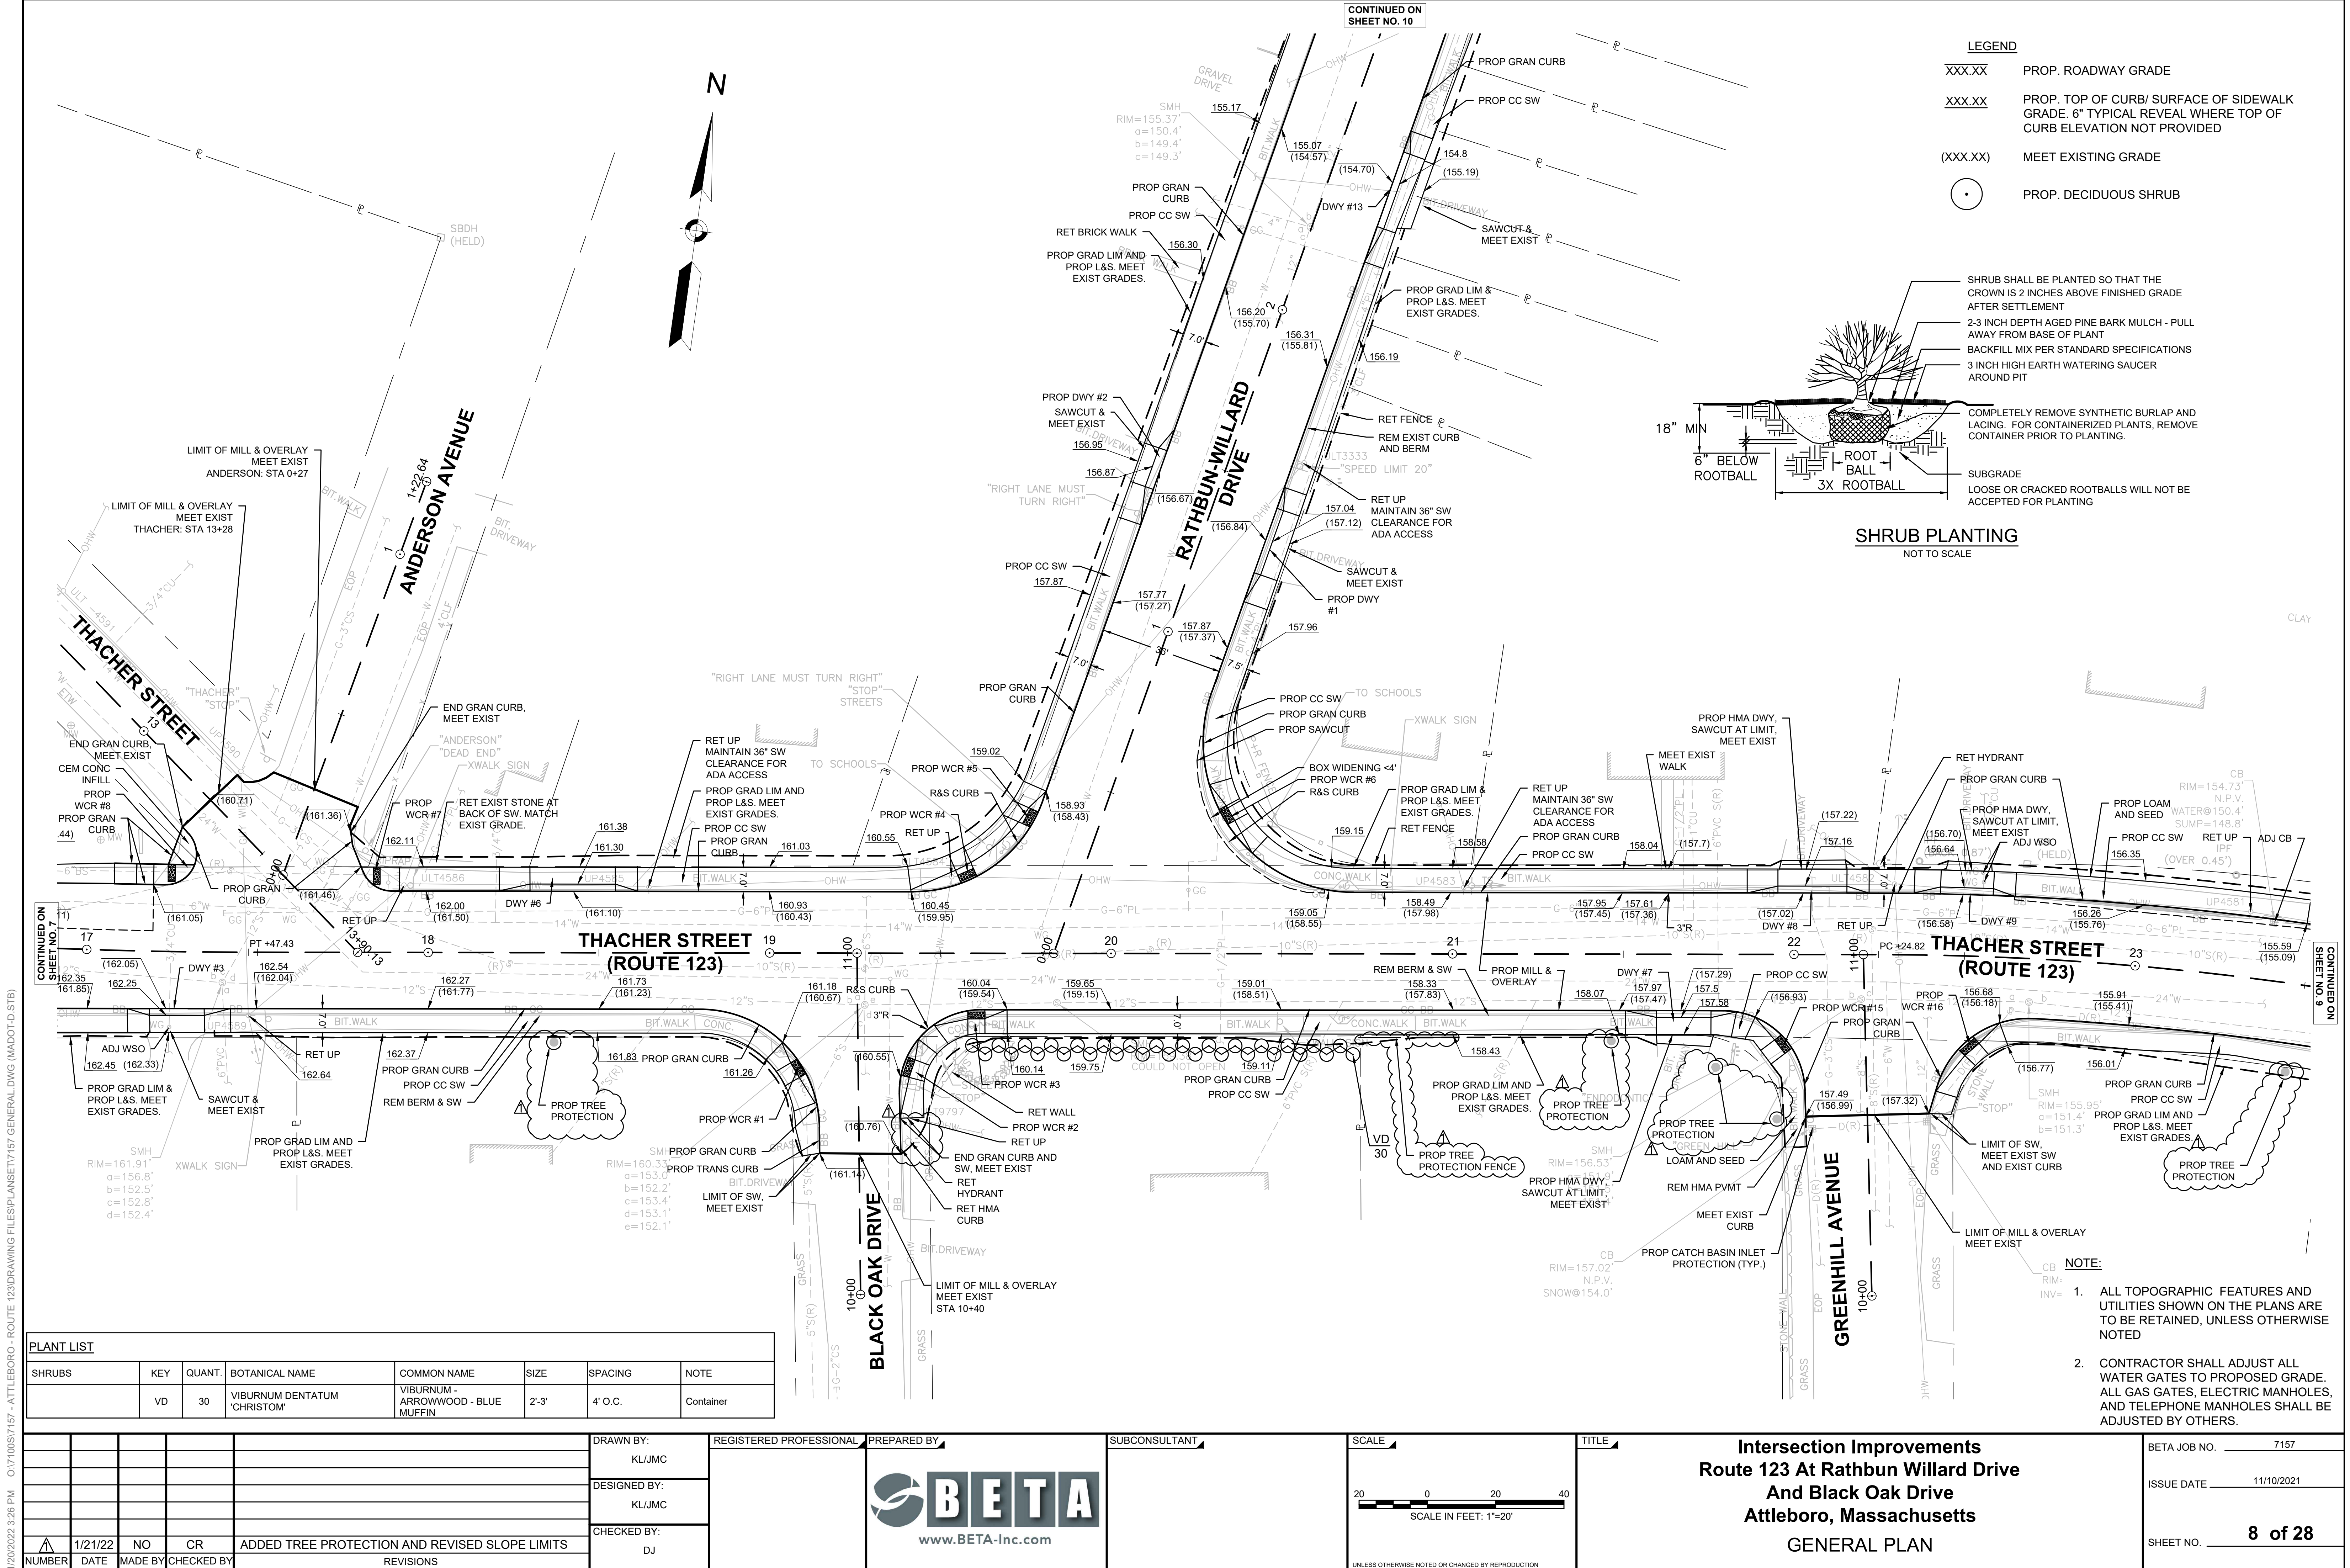


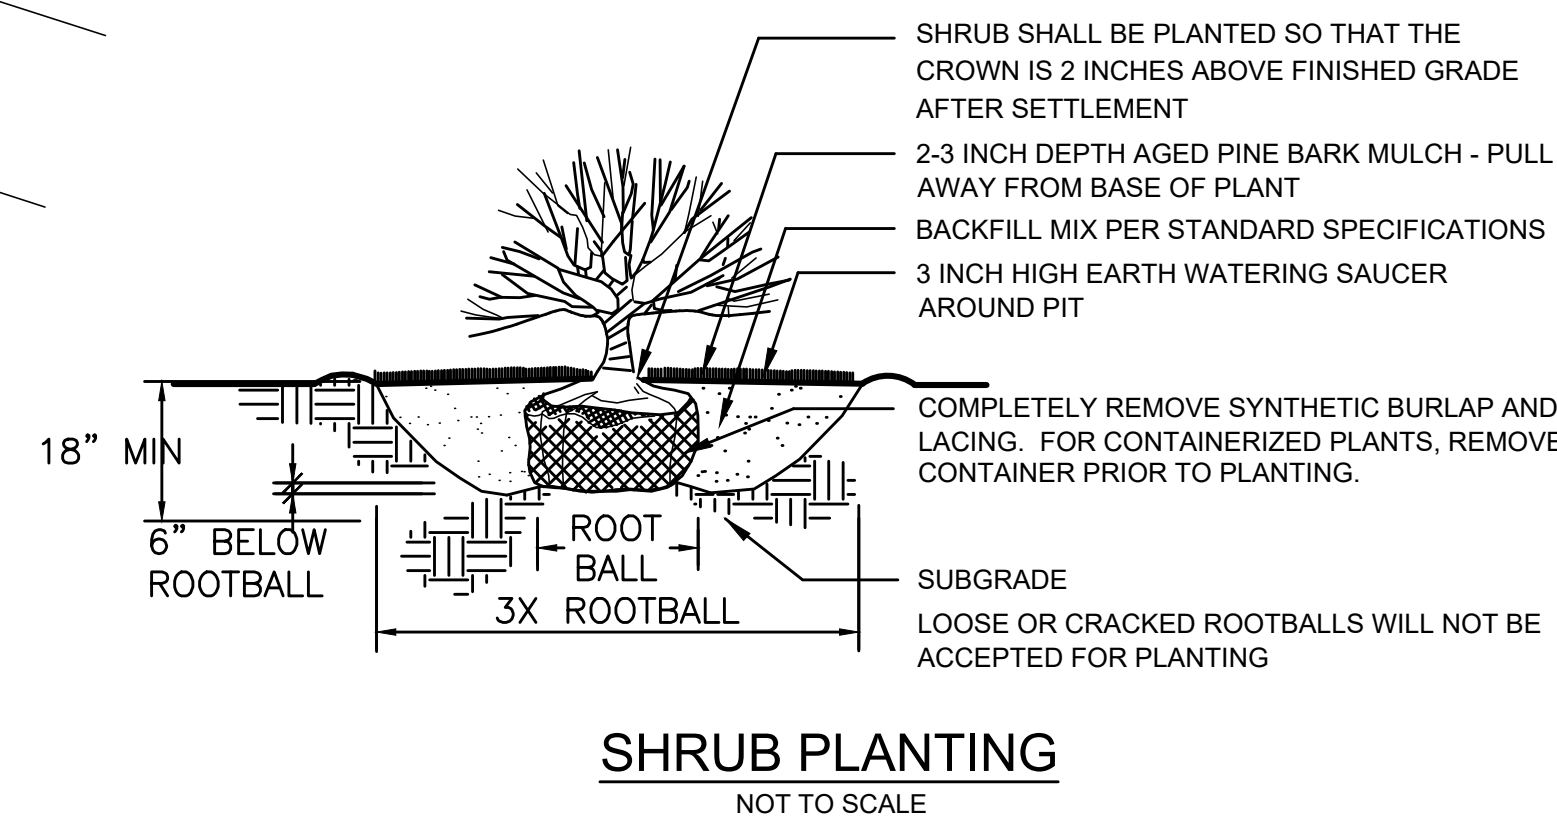


- LEGEND**
- XXX.XX PROP. ROADWAY GRADE
 - XXX.XX PROP. TOP OF CURB/ SURFACE OF SIDEWALK GRADE. 6" TYPICAL REVEAL WHERE TOP OF CURB ELEVATION NOT PROVIDED
 - (XXX.XX) MEET EXISTING GRADE
 - PROP. DECIDUOUS SHRUB




PLANT LIST						
SHRUBS	KEY	QUANT.	BOTANICAL NAME	COMMON NAME	SIZE	SPACING
	VD	30	VIBURNUM DENTATUM 'CHRISTOM'	VIBURNUM - ARROWWOOD - BLUE MUFFIN	2'-3'	4' O.C.

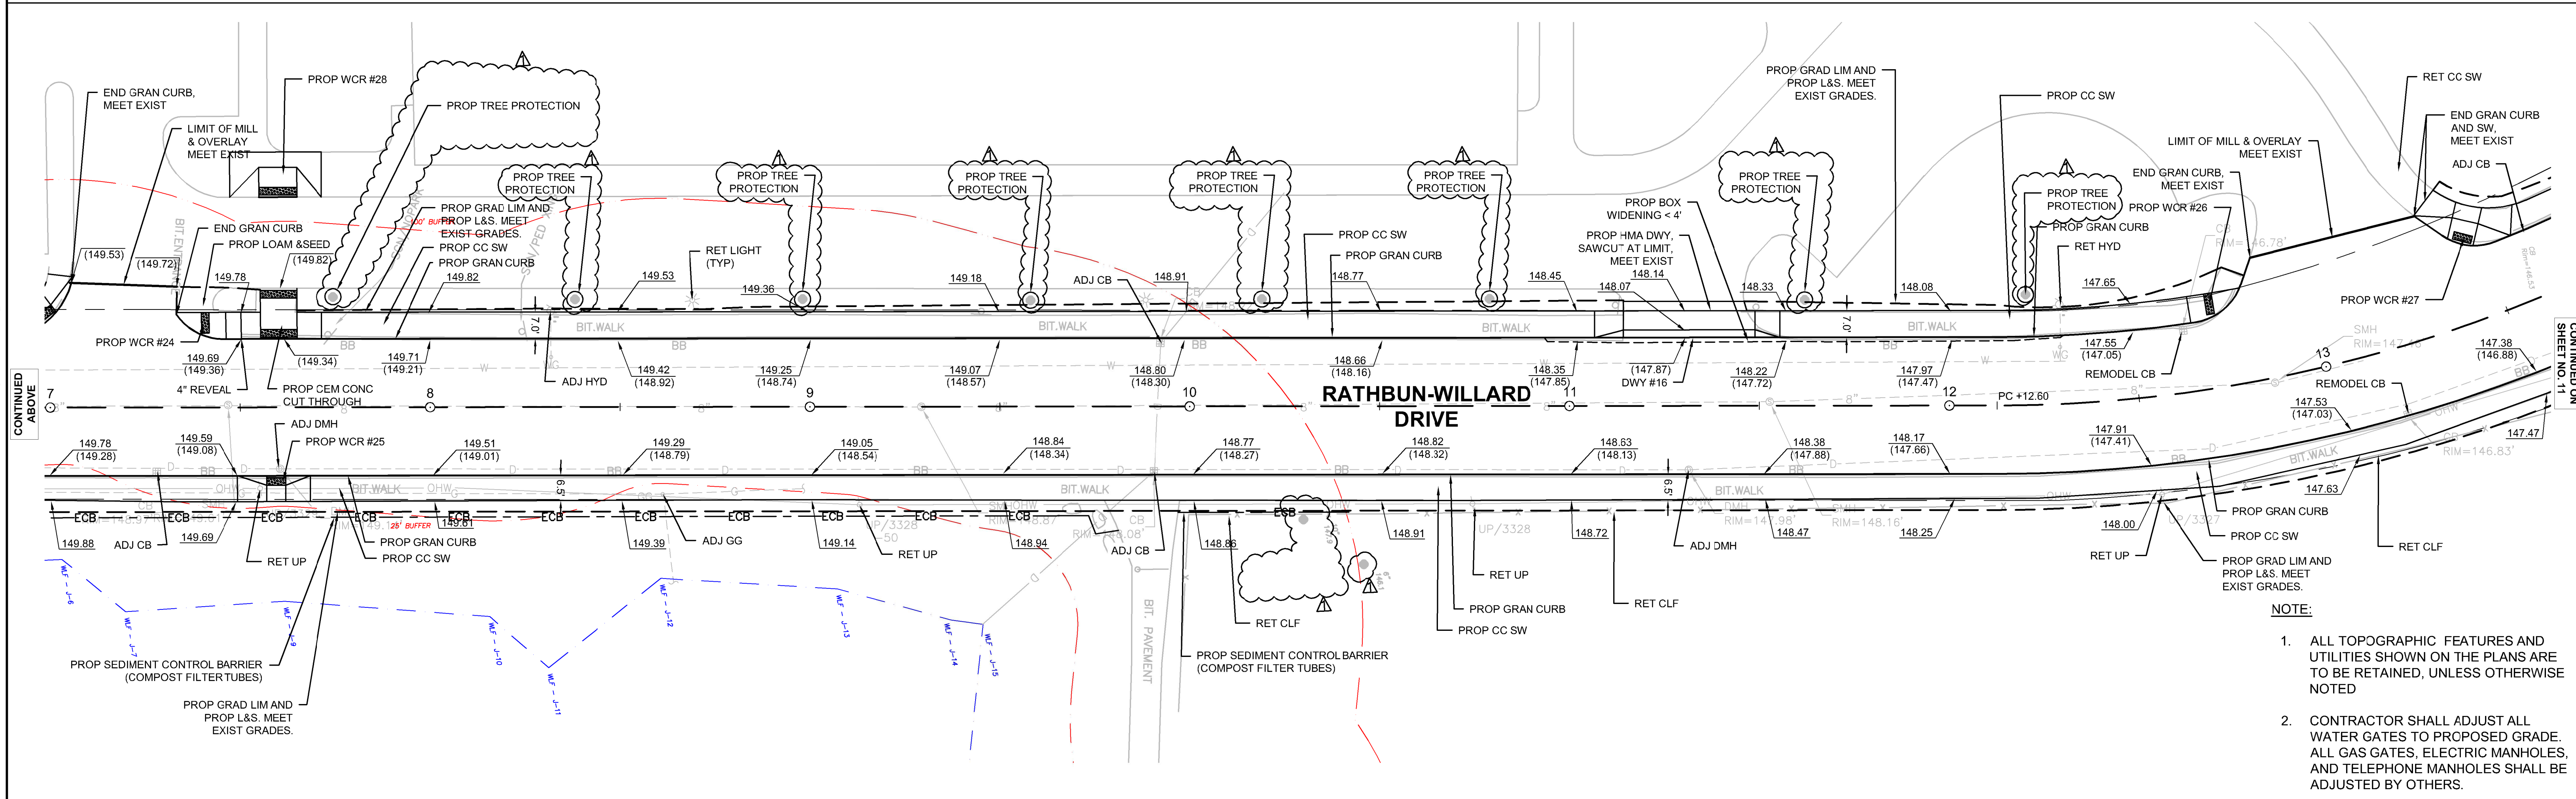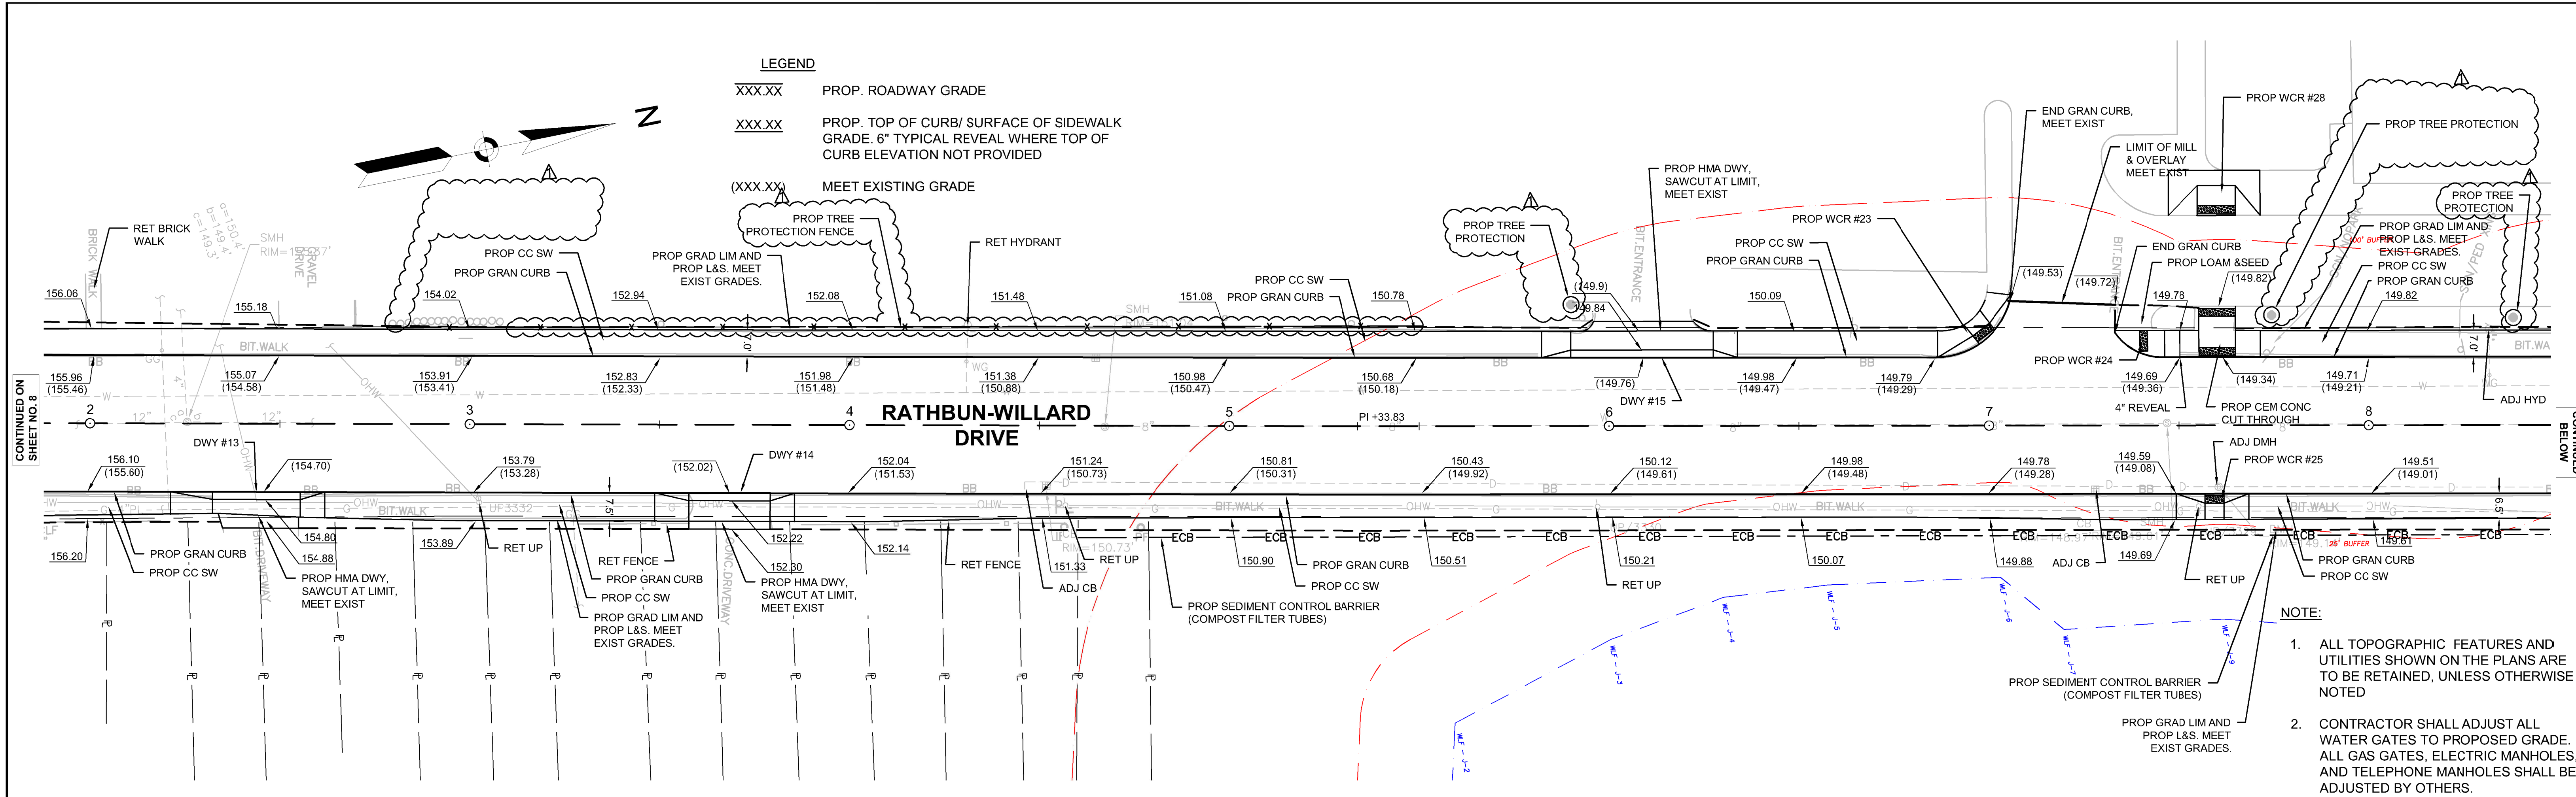DRAWN BY: KLJMC				REGISTERED PROFESSIONAL		PREPARED BY: BETA		SUBCONSULTANT		SCALE: 20 0 20 40 SCALE IN FEET: 1"=20'		TITLE: Intersection Improvements Route 123 At Rathbun Willard Drive And Black Oak Drive Attleboro, Massachusetts GENERAL PLAN		BETA JOB NO. 7157	
DESIGNED BY: KLJMC														ISSUE DATE: 11/10/2021	
CHECKED BY: DJ														SHEET NO. 8 of 28	
1/21/22 NO CR ADDED TREE PROTECTION AND REVISED SLOPE LIMITS															
NUMBER DATE MADE BY CHECKED BY															



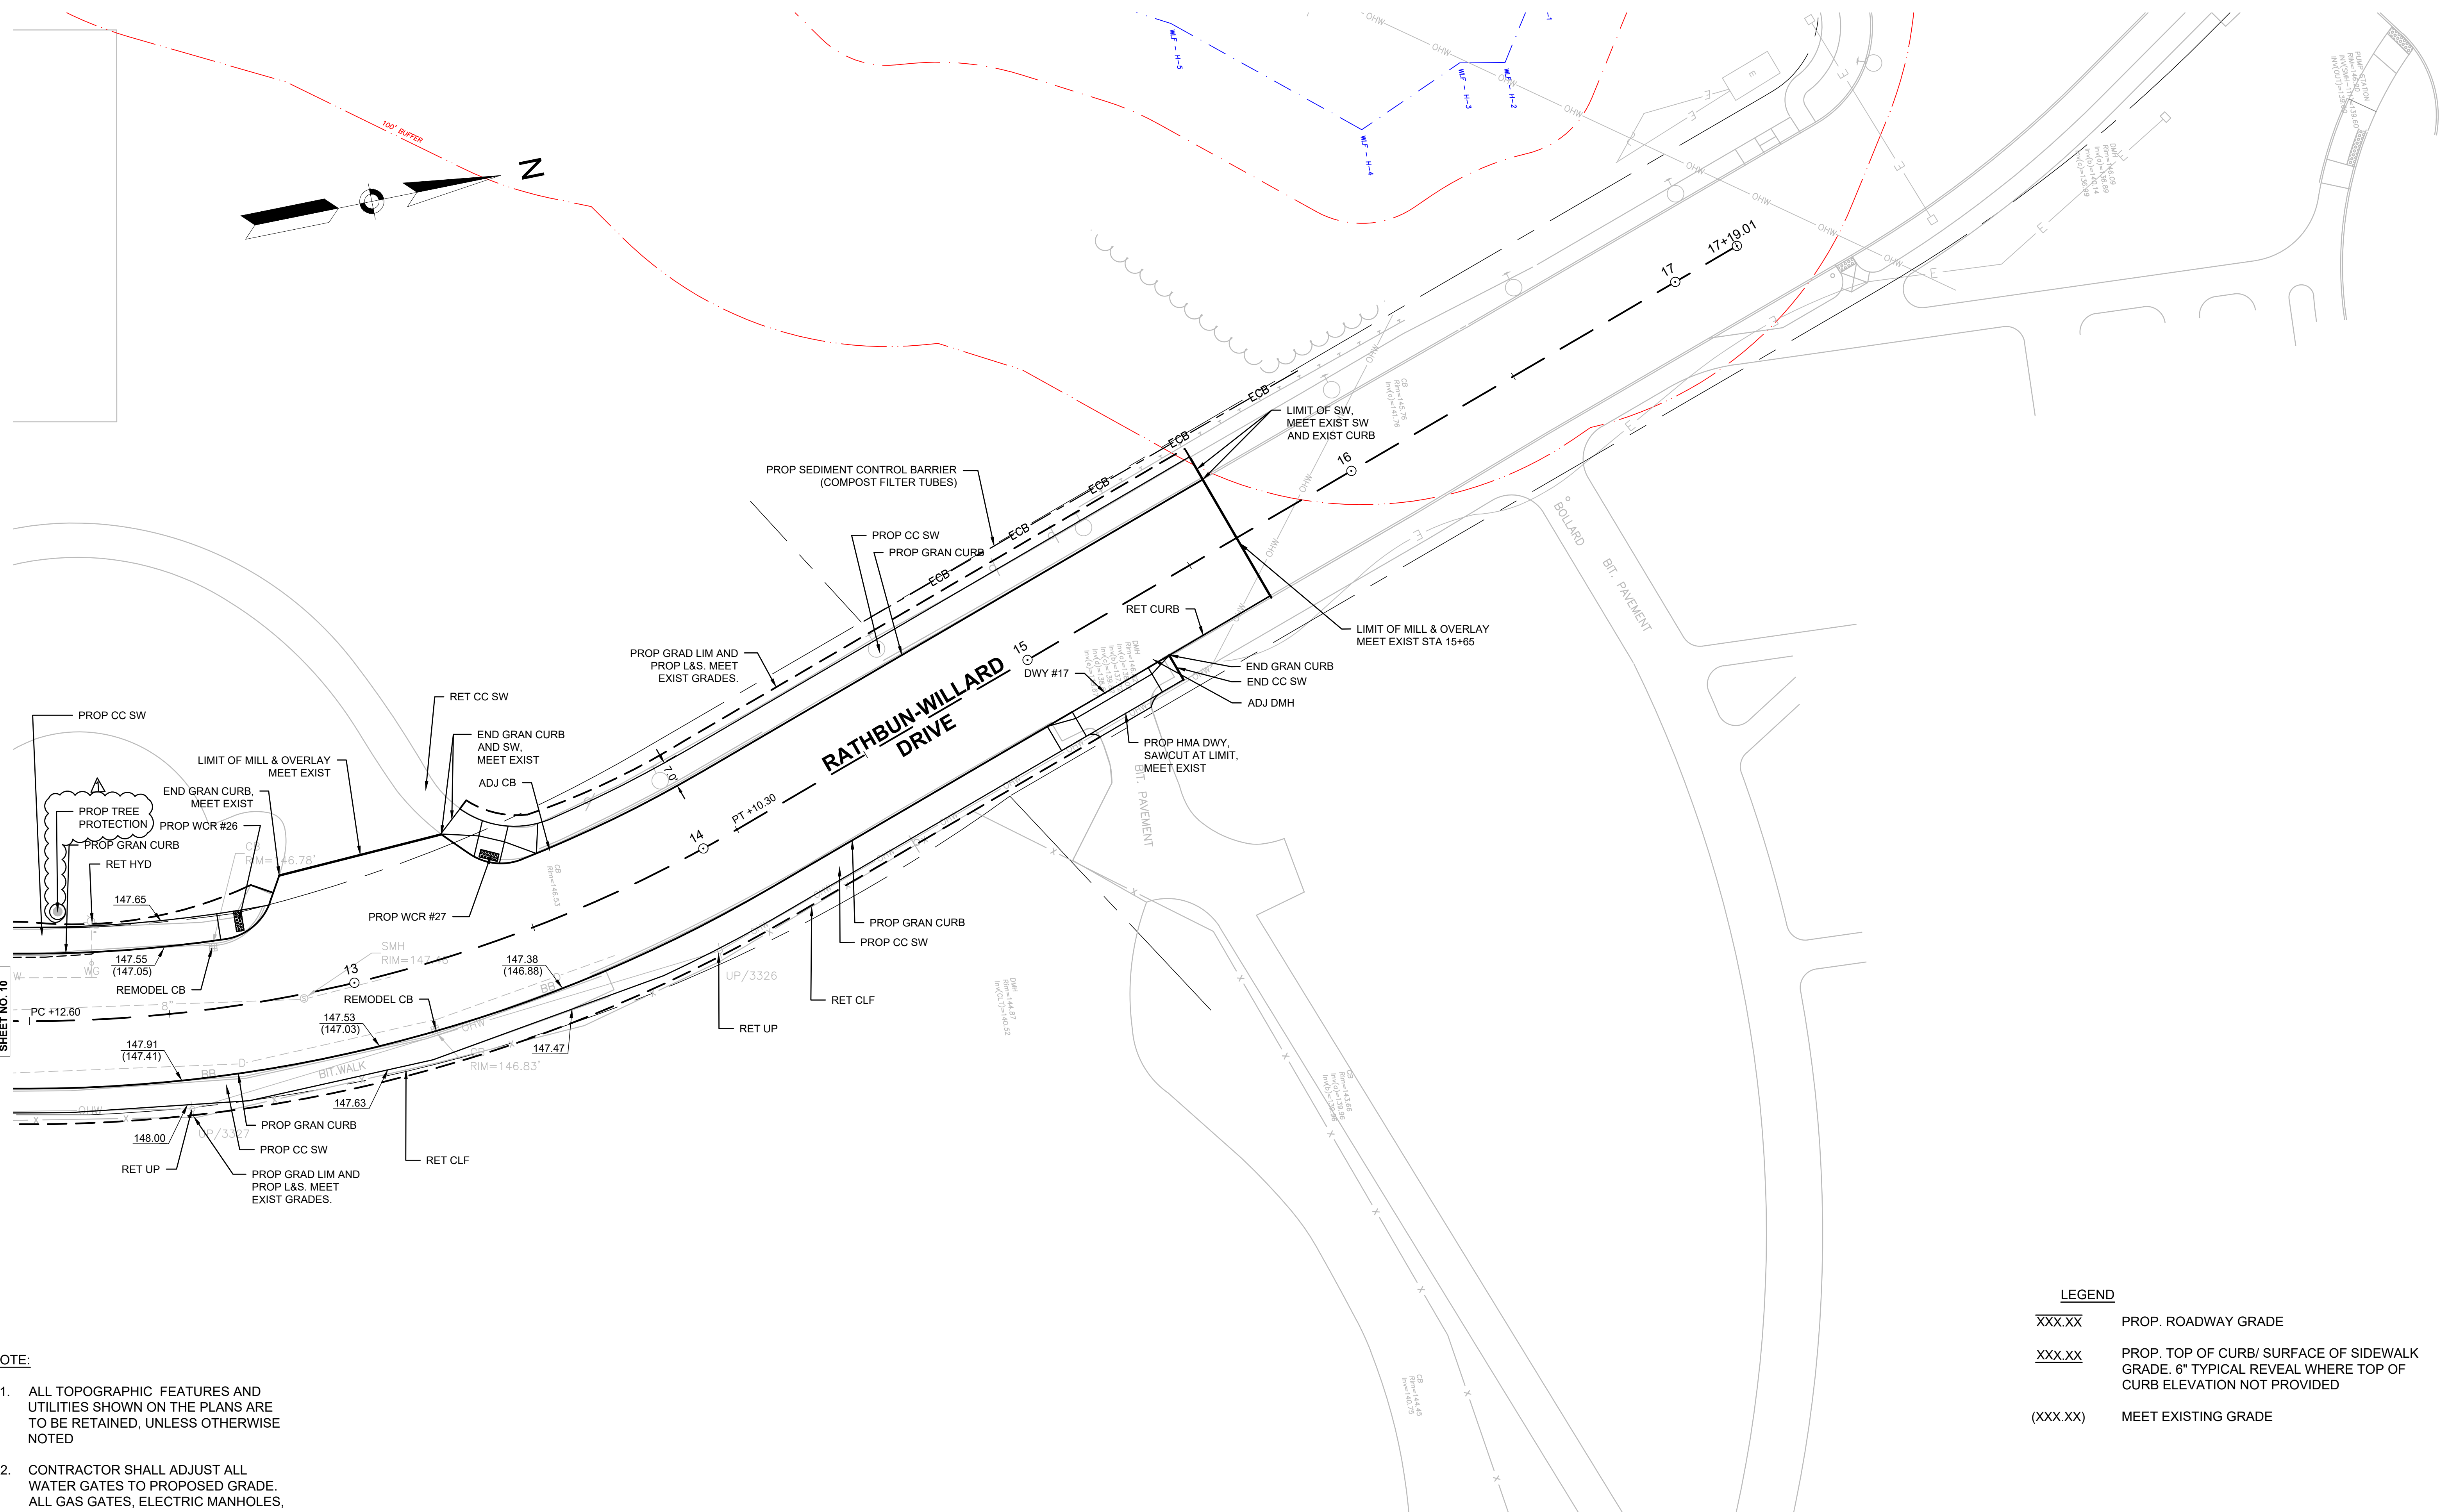


				DRAWN BY: KL/JMC		<div>REGISTERED PROFESSIONAL</div> <div></div> <div>www.BETA-Inc.com</div>	SUBCONSULTANT		<div>SCALE</div> <div></div> <div>SCALE IN FEET: 1"=20'</div> <div>UNLESS OTHERWISE NOTED OR CHANGED BY REPRODUCTION</div>		<div>TITLE</div> <div>Intersection Improvements Route 123 At Rathbun Willard Drive And Black Oak Drive Attleboro, Massachusetts GENERAL PLAN</div>		BETA JOB NO. 7157	
				DESIGNED BY: KL/JMC			ISSUE DATE 11/10/2021							
				CHECKED BY: DJ			SHEET NO. 10 of 28							
<div><div></div><div>1/21/22</div><div>NO</div><div>CR</div><div>ADDED TREE PROTECTION</div></div>														
NUMBER		DATE		MADE BY		CHECKED BY		REVISIONS						



NOTE:

1. ALL TOPOGRAPHIC FEATURES AND UTILITIES SHOWN ON THE PLANS ARE TO BE RETAINED, UNLESS OTHERWISE NOTED
2. CONTRACTOR SHALL ADJUST ALL WATER GATES TO PROPOSED GRADE. ALL GAS GATES, ELECTRIC MANHOLES AND TELEPHONE MANHOLES SHALL BE ADJUSTED BY OTHERS.

					DRAWN BY: KL/JMC	REGISTERED PROFESSIONAL	PREPARED BY	SUBCONSULTANT	SCALE	TITLE	BETA JOB NO. 7157
					DESIGNED BY: KL/JMC		 www.BETA-inc.com		 SCALE IN FEET: 1"=20"	Intersection Improvements Route 123 At Rathbun Willard Drive And Black Oak Drive Attleboro, Massachusetts GENERAL PLAN	ISSUE DATE 11/10/2021
					CHECKED BY: DJ				UNLESS OTHERWISE NOTED OR CHANGED BY REPRODUCTION		SHEET NO. 11 of 28
 NUMBER	1/21/22 DATE	NO MADE BY	CR CHECKED BY	ADDED TREE PROTECTION REVISIONS							